

11-DEC-2012 14:35

Chad. Havens

TIME\$\$\$ 006043cp11
8825Full.pen


R:\07400004\006043\GDN\As_Builts\GDN\006043cp11.dgn

STATE GA PROJECT NUMBER CSNHS-0006-00(043)

SHEET NO. 43 TOTAL SHEETS 668

AS-BUILT PLANS 12/12/12

DRAWING NO.

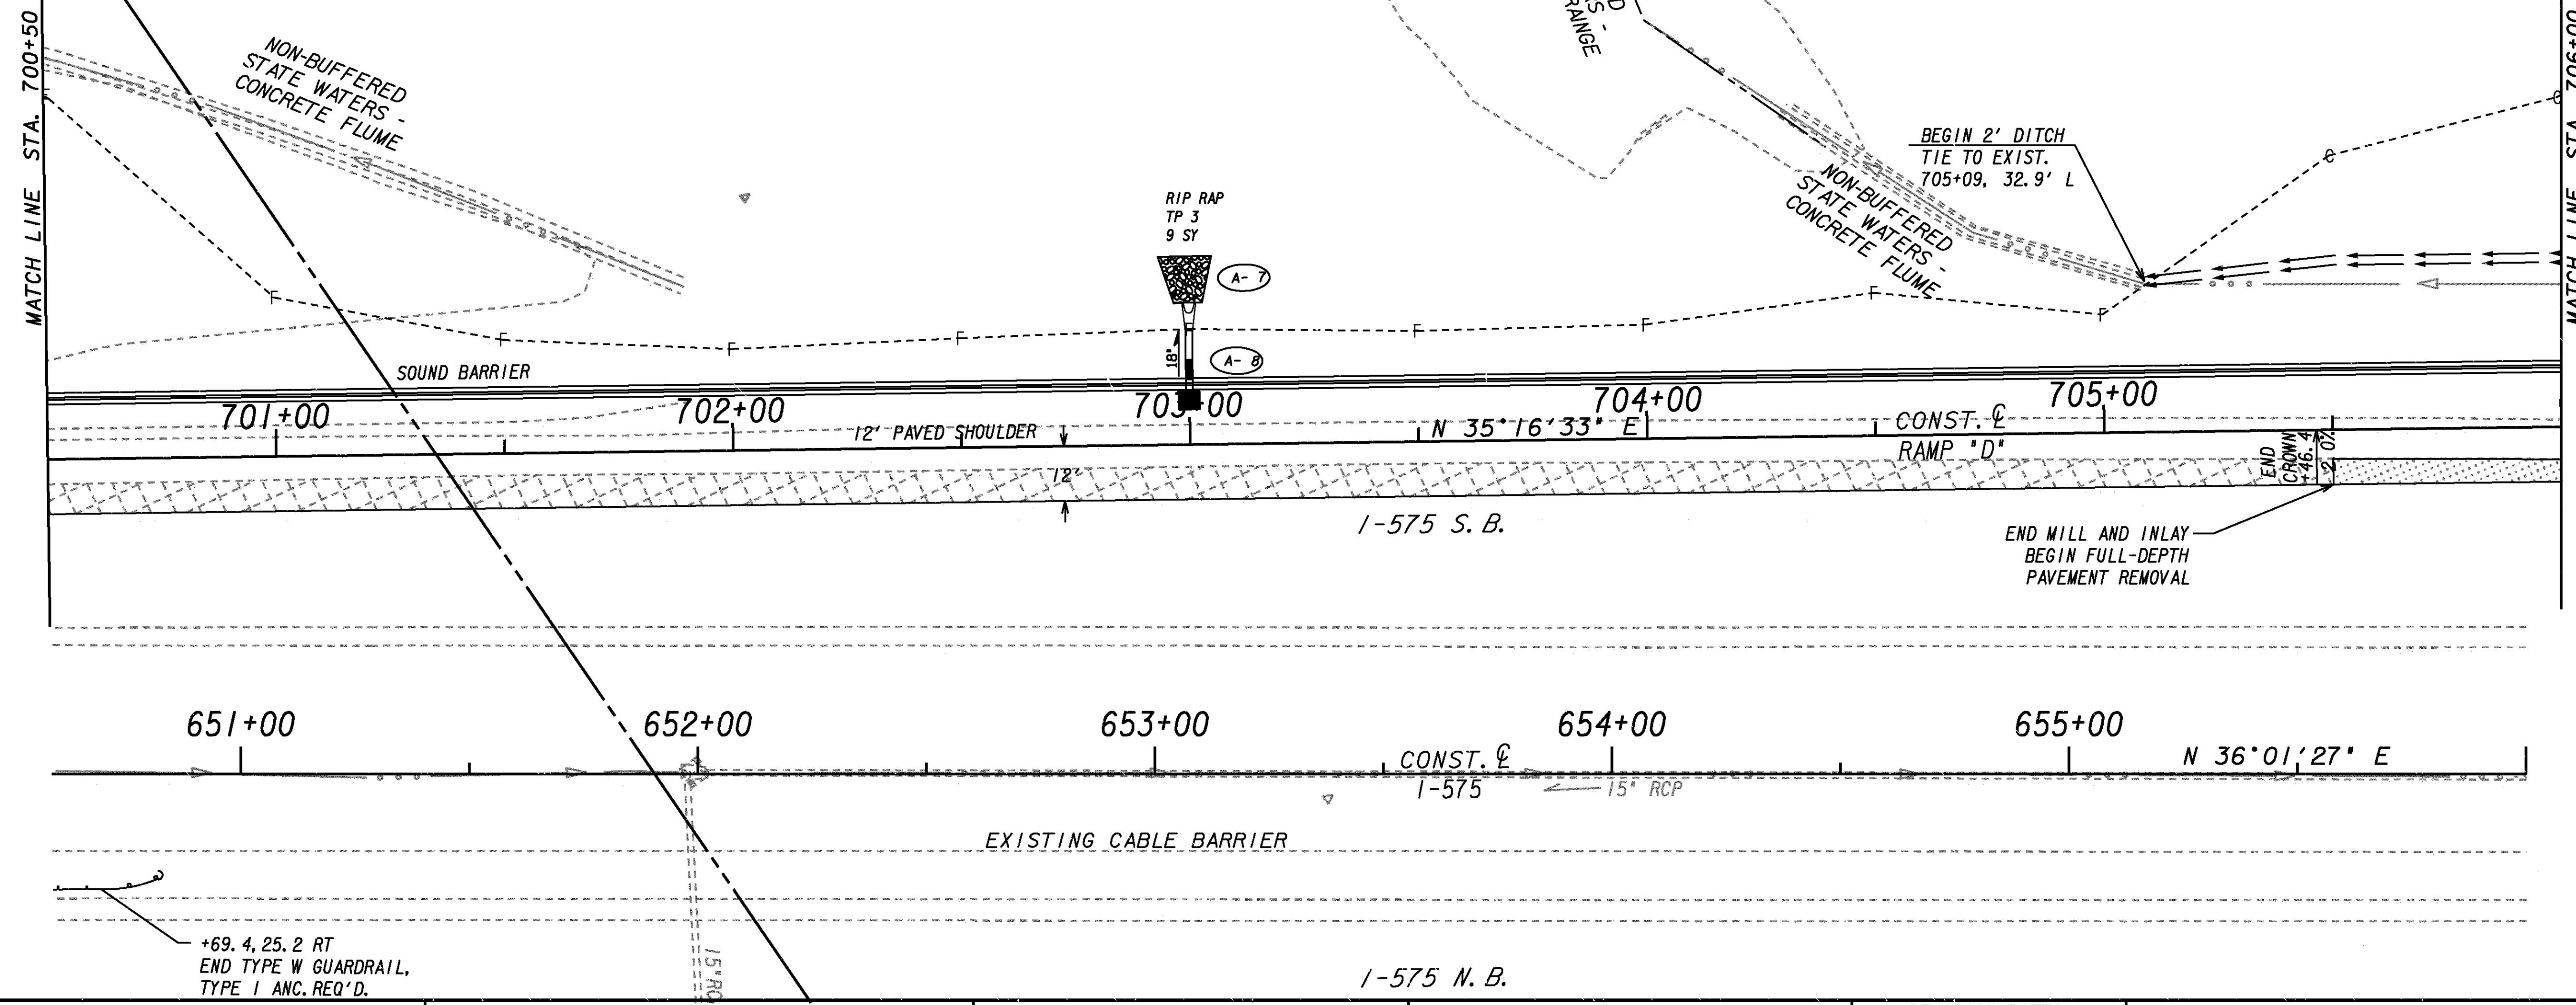

PROPERTY AND EXISTING R/W LINE ————— P —————
 REQUIRED R/W LINE ————— G —————
 CONSTRUCTION LIMITS ————— G F —————
 EASEMENT FOR CONSTR & MAINTENANCE OF SLOPES
 EASEMENT FOR CONSTR OF SLOPES
 EASEMENT FOR CONSTR OF DRIVES

BEGIN LIMIT OF ACCESS.....BLA
 END LIMIT OF ACCESS.....ELA
 LIMIT OF ACCESS
 REQ'D R/W & LIMIT OF ACCESS

THE LPA GROUP
LPA
 TRANSPORTATION CONSULTANTS
 3595 ENGINEERING DRIVE
 NORCROSS, GEORGIA 30092
 (770) 263-9118



REVISION DATES

STATE OF GEORGIA
DEPARTMENT OF TRANSPORTATION

OFFICE: INNOVATIVE PROGRAM DELIVERY

MAINLINE PLAN

I-575 SB AUXILIARY LANE

I-575 STA. 650+50 TO

SB ENTR. RAMP D STA. 700+00

DRAWING NO.

13-011